# zero carbon house

AS BUILT

**Section A March 2008 1:50 at A2 103.04 H**
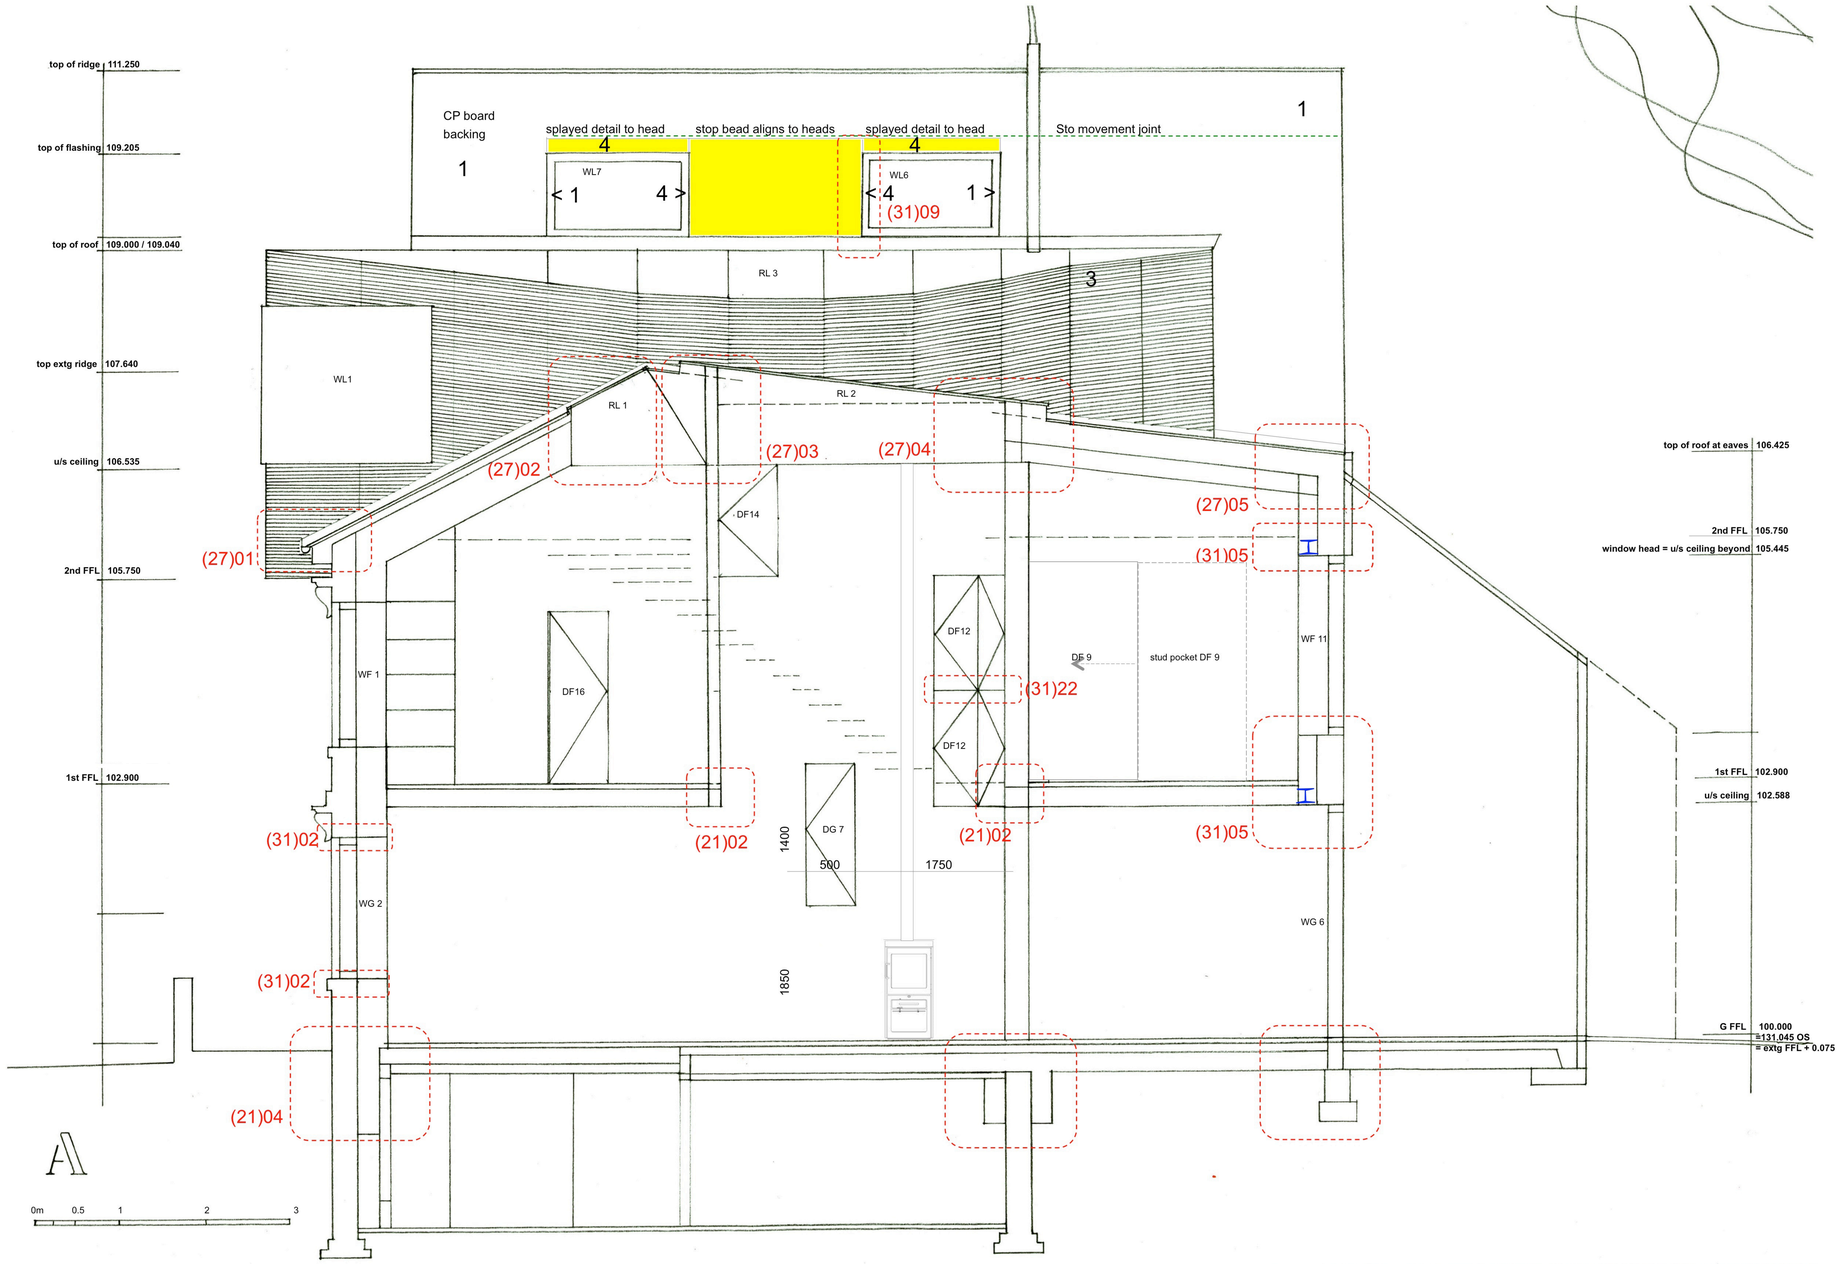
A: redrawn B:6.7.8 WL7, steels, notes C: 20.9.8: MVHR housing added D:18.10.8: Stove & flue added.
E: 3.1.9: levels, door & window nos, DF9 size & stud, DG7 dims. F:28.3.9: splay window heads, render colour keyed. G: 19.4.9: Render mvt joint added. H: 24.4.10: as built.